


NOTE: FIELD MEASURE
BEFORE BEGINNING
CONSTRUCTION DRAWINGS

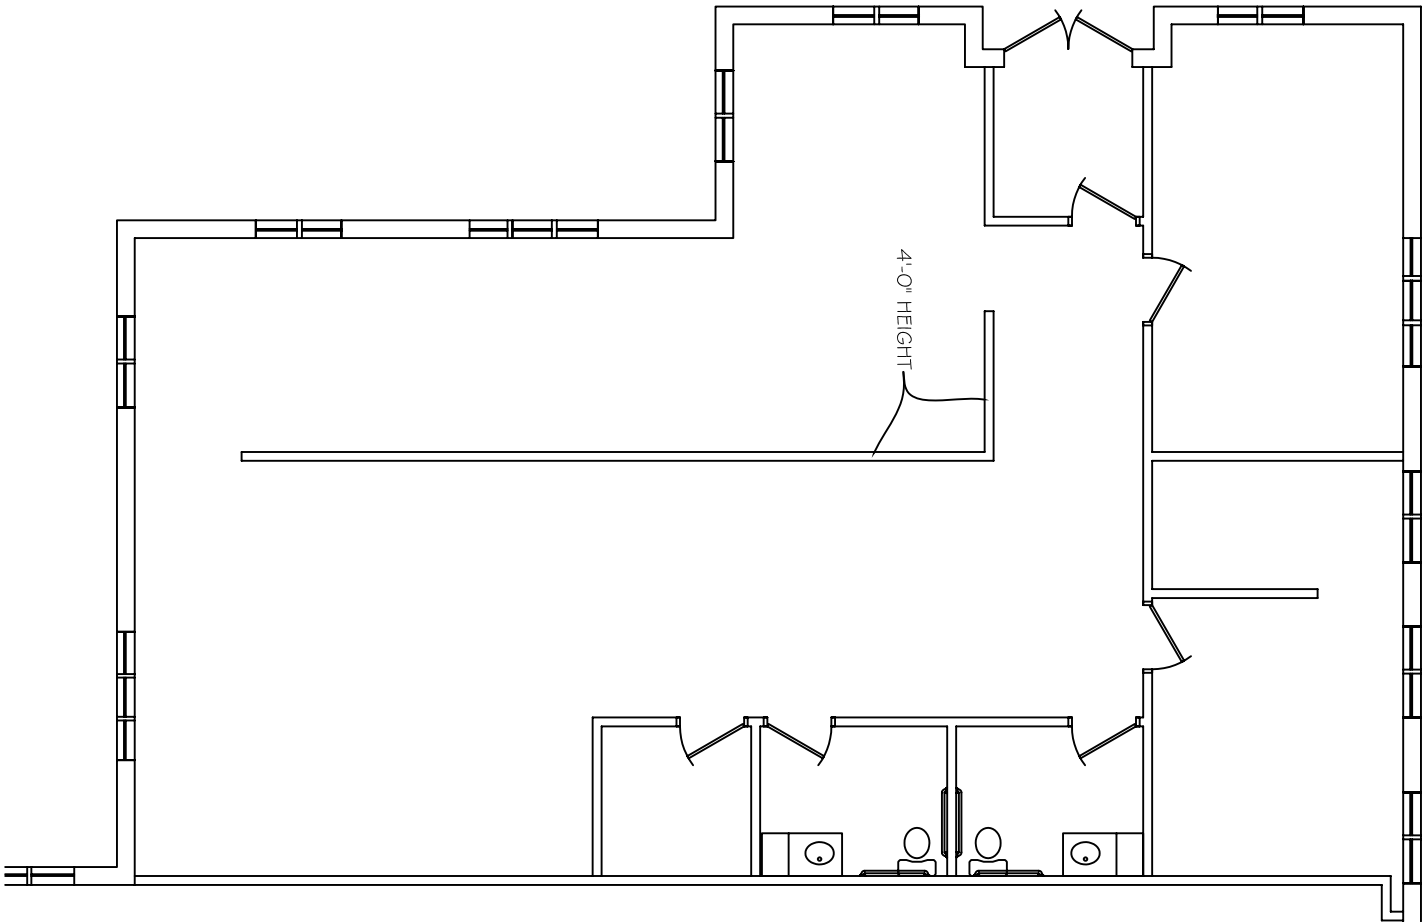

IT IS A VIOLATION FOR ANY PERSON TO ALTER ANY ITEM ON THIS DOCUMENT IN ANY WAY WITHOUT THE WRITTEN RELEASE FROM GETSLOFF DESIGN GROUP. THESE DRAWINGS ARE THE PROPERTY OF GETSLOFF DESIGN GROUP AND ARE NOT TO BE USED, COPIED OR APPLIED WITHOUT WRITTEN CONSENT.

GETSLOFF
Design Group

777 Canal View Blvd. - Rochester, New York 14623
Phone: 585.475.0990 - Fax: 585.475.0991

SK-1

JOB NAME:	500 CORNERSTONE CTR
TITLE:	SUITE FLOOR PLAN
SCALE:	NOT TO SCALE
PROJECT #	#
DATE:	3/25/08